



Brooks Properties  
9 Red Roof Lane  
Salem, NH 03079

Building B  
8 Industrial Way  
Salem, NH 03079

DATE: August 30, 2018



REVISIONS:

|  |  |
|--|--|
|  |  |
|  |  |
Suite 1B  
As-Built

SCALE: 1/4" = 1'-0"  
DRAWN BY: LL

EX.1

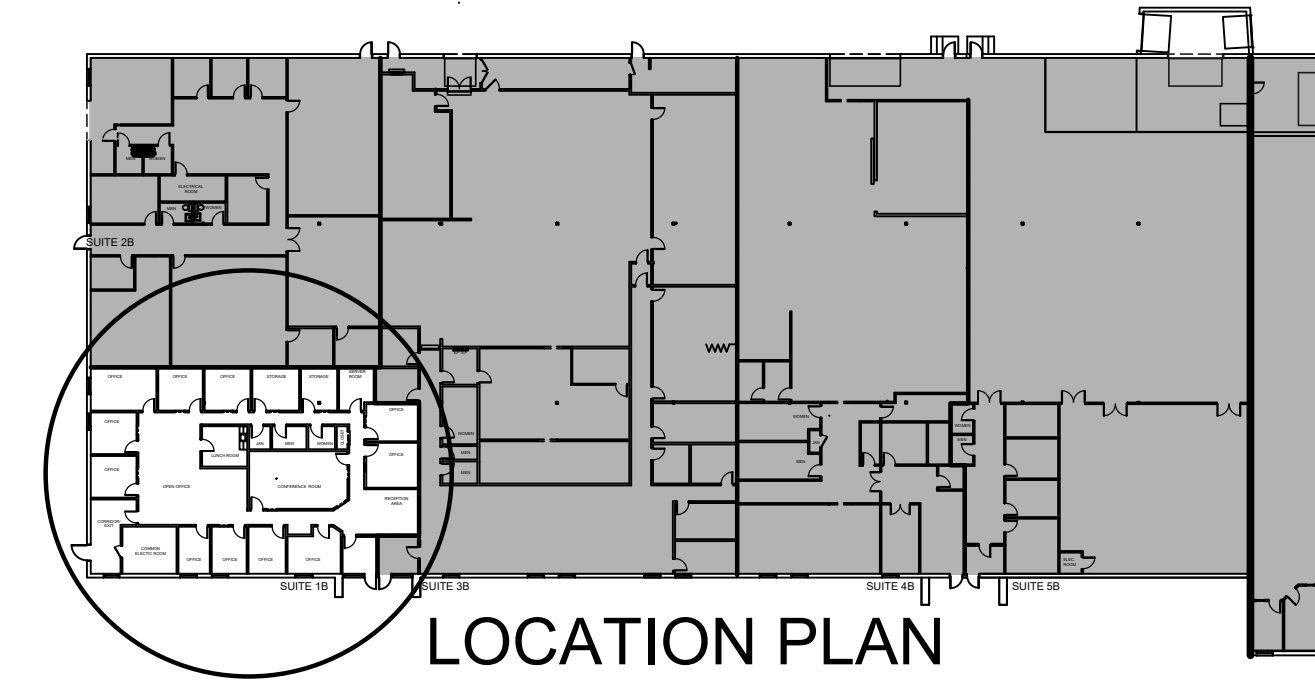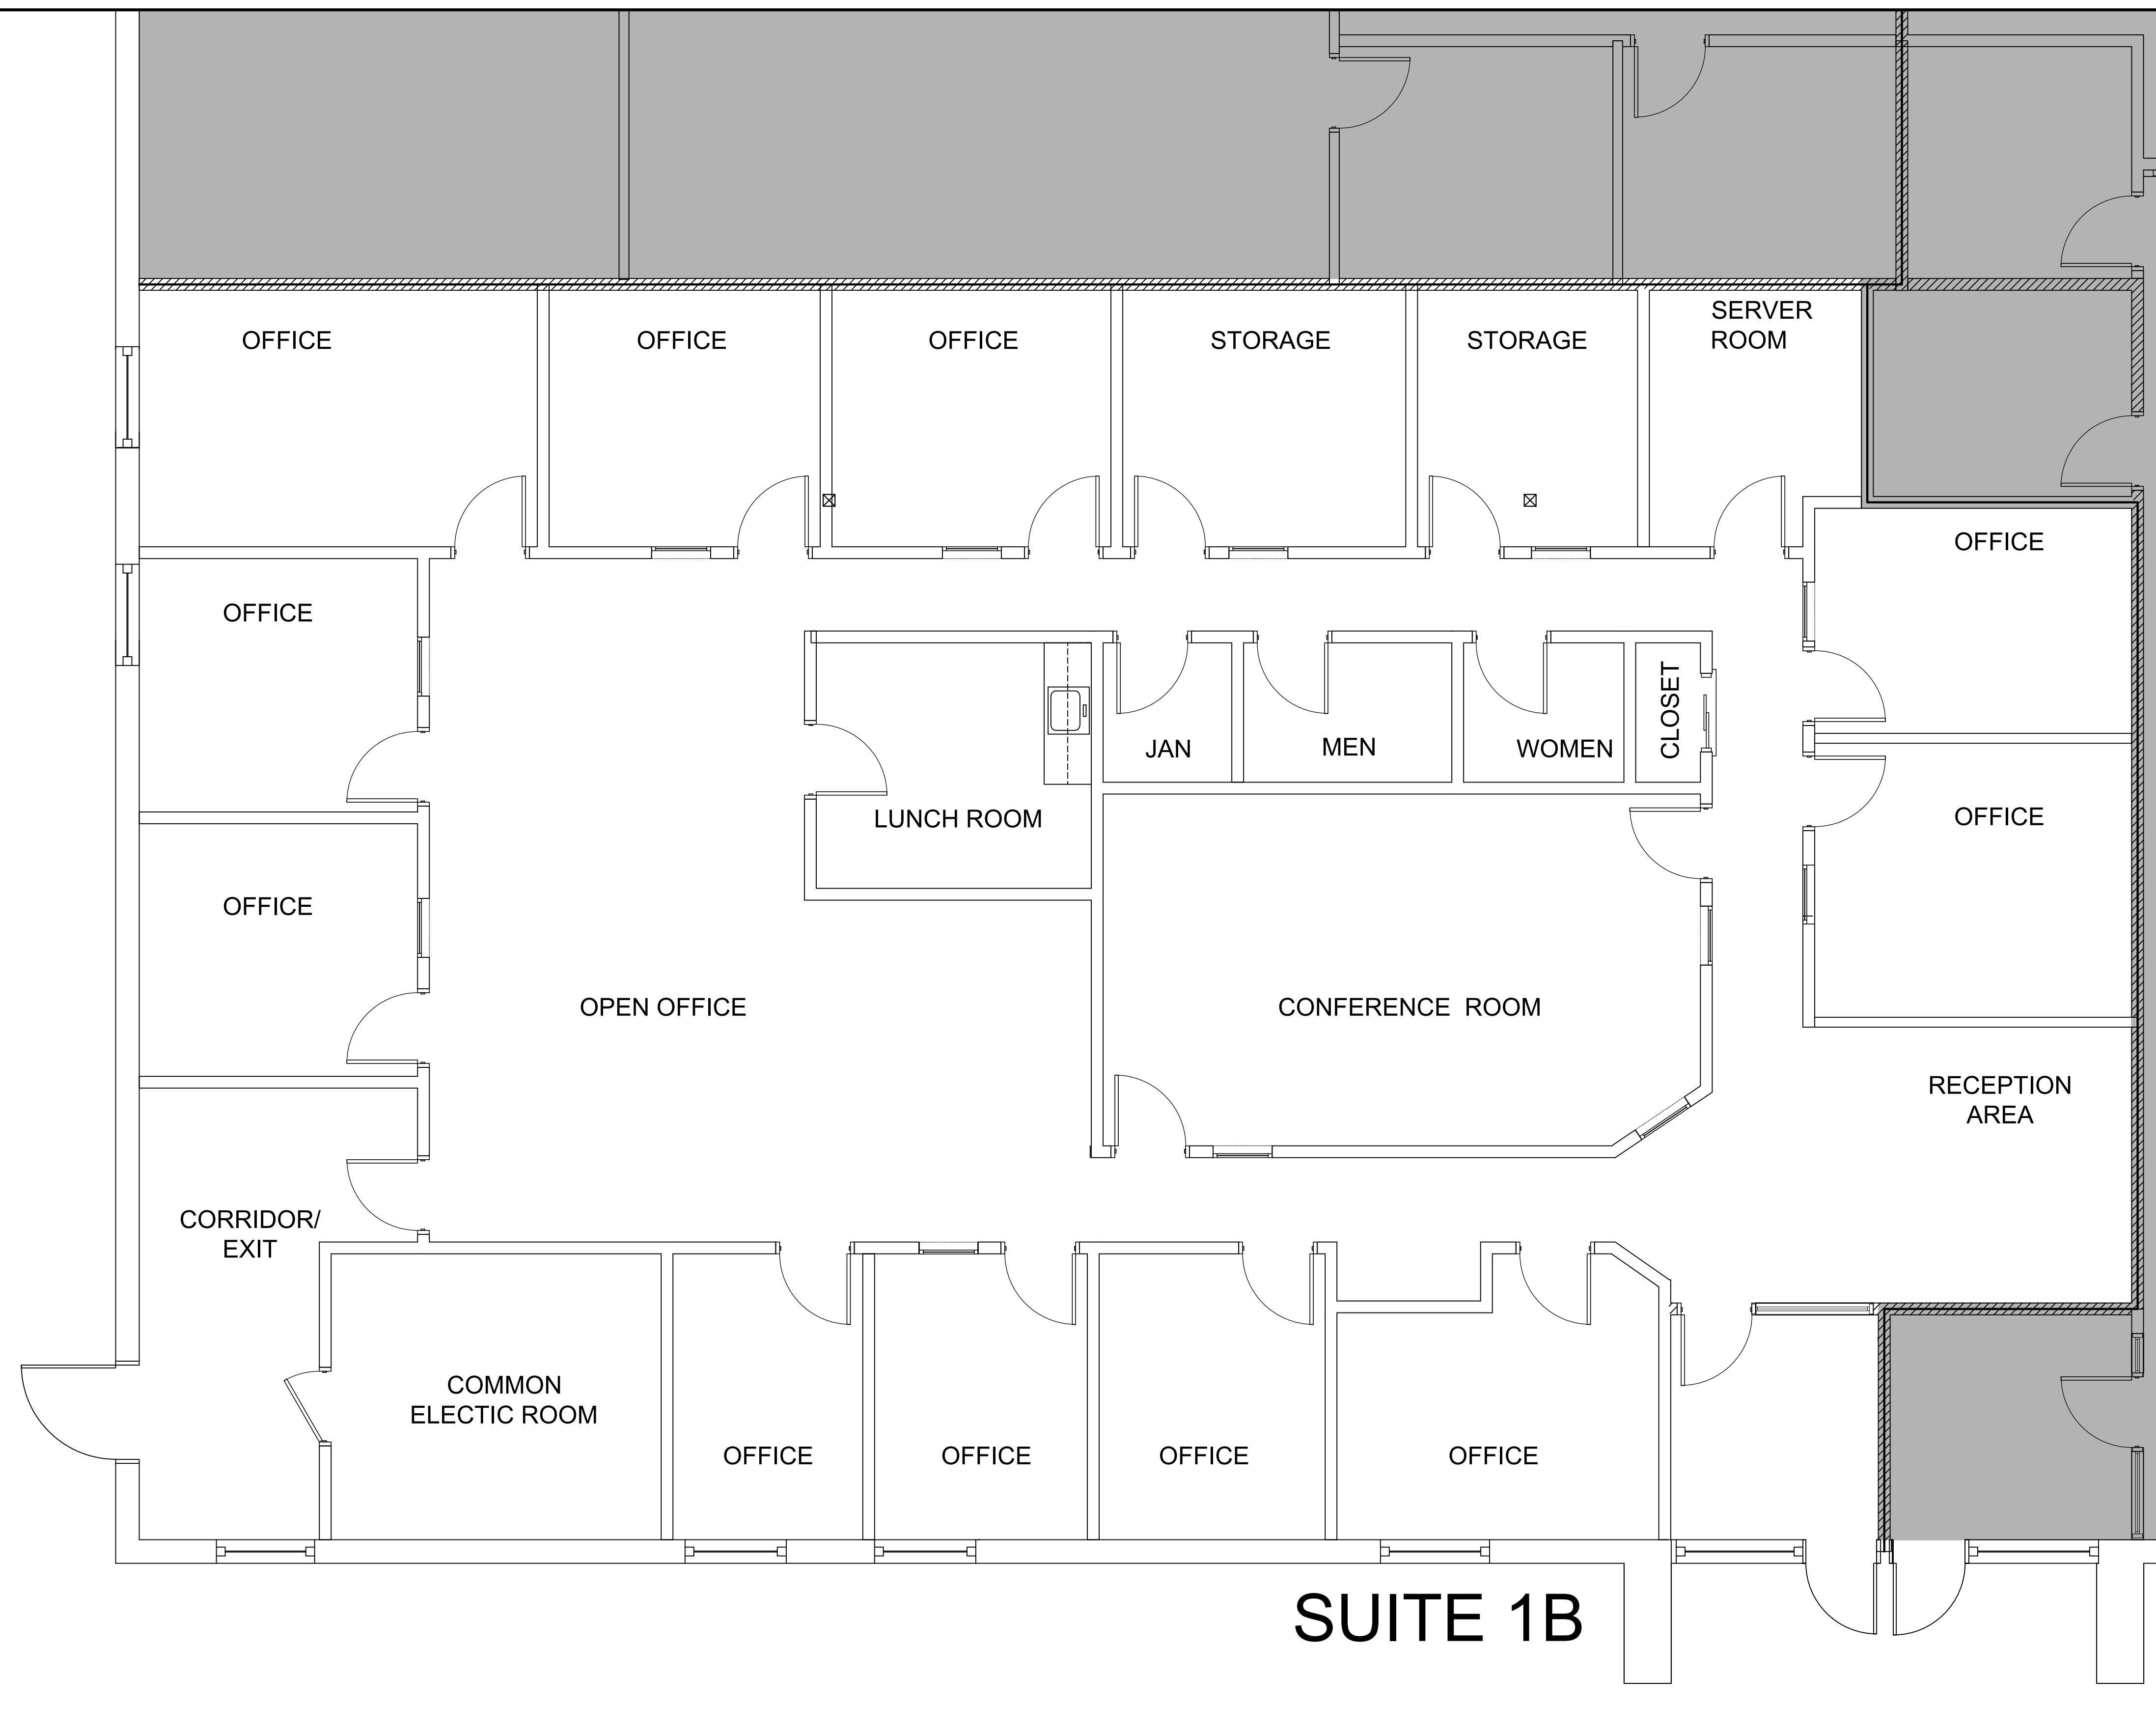

LOCATION PLAN