



Brooks Properties  
9 Red Roof Lane  
Salem NH 03079



Building B  
8 Industrial Way  
Salem, NH 03079

DATE: August 30, 2018  
REVISIONS:


Suite 3B  
As-Built

SCALE: 1/8" = 1'-0"  
DRAWN BY: LL

EX.1

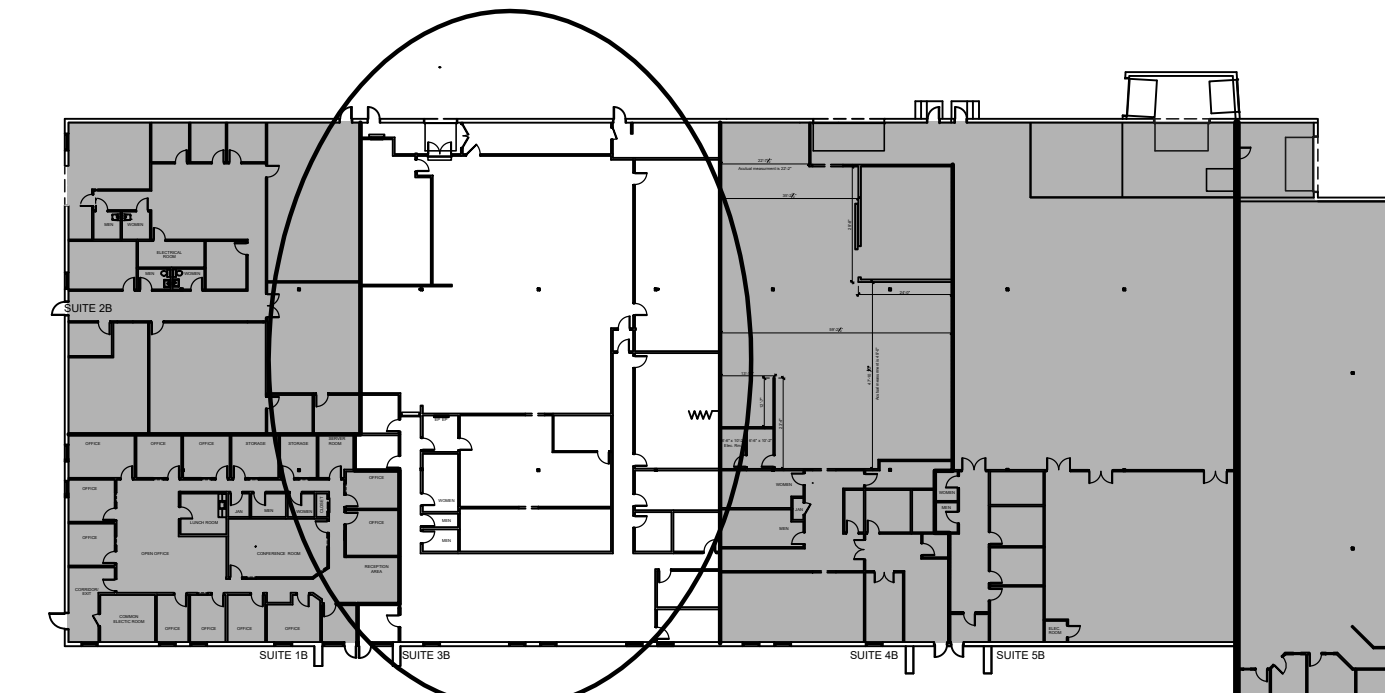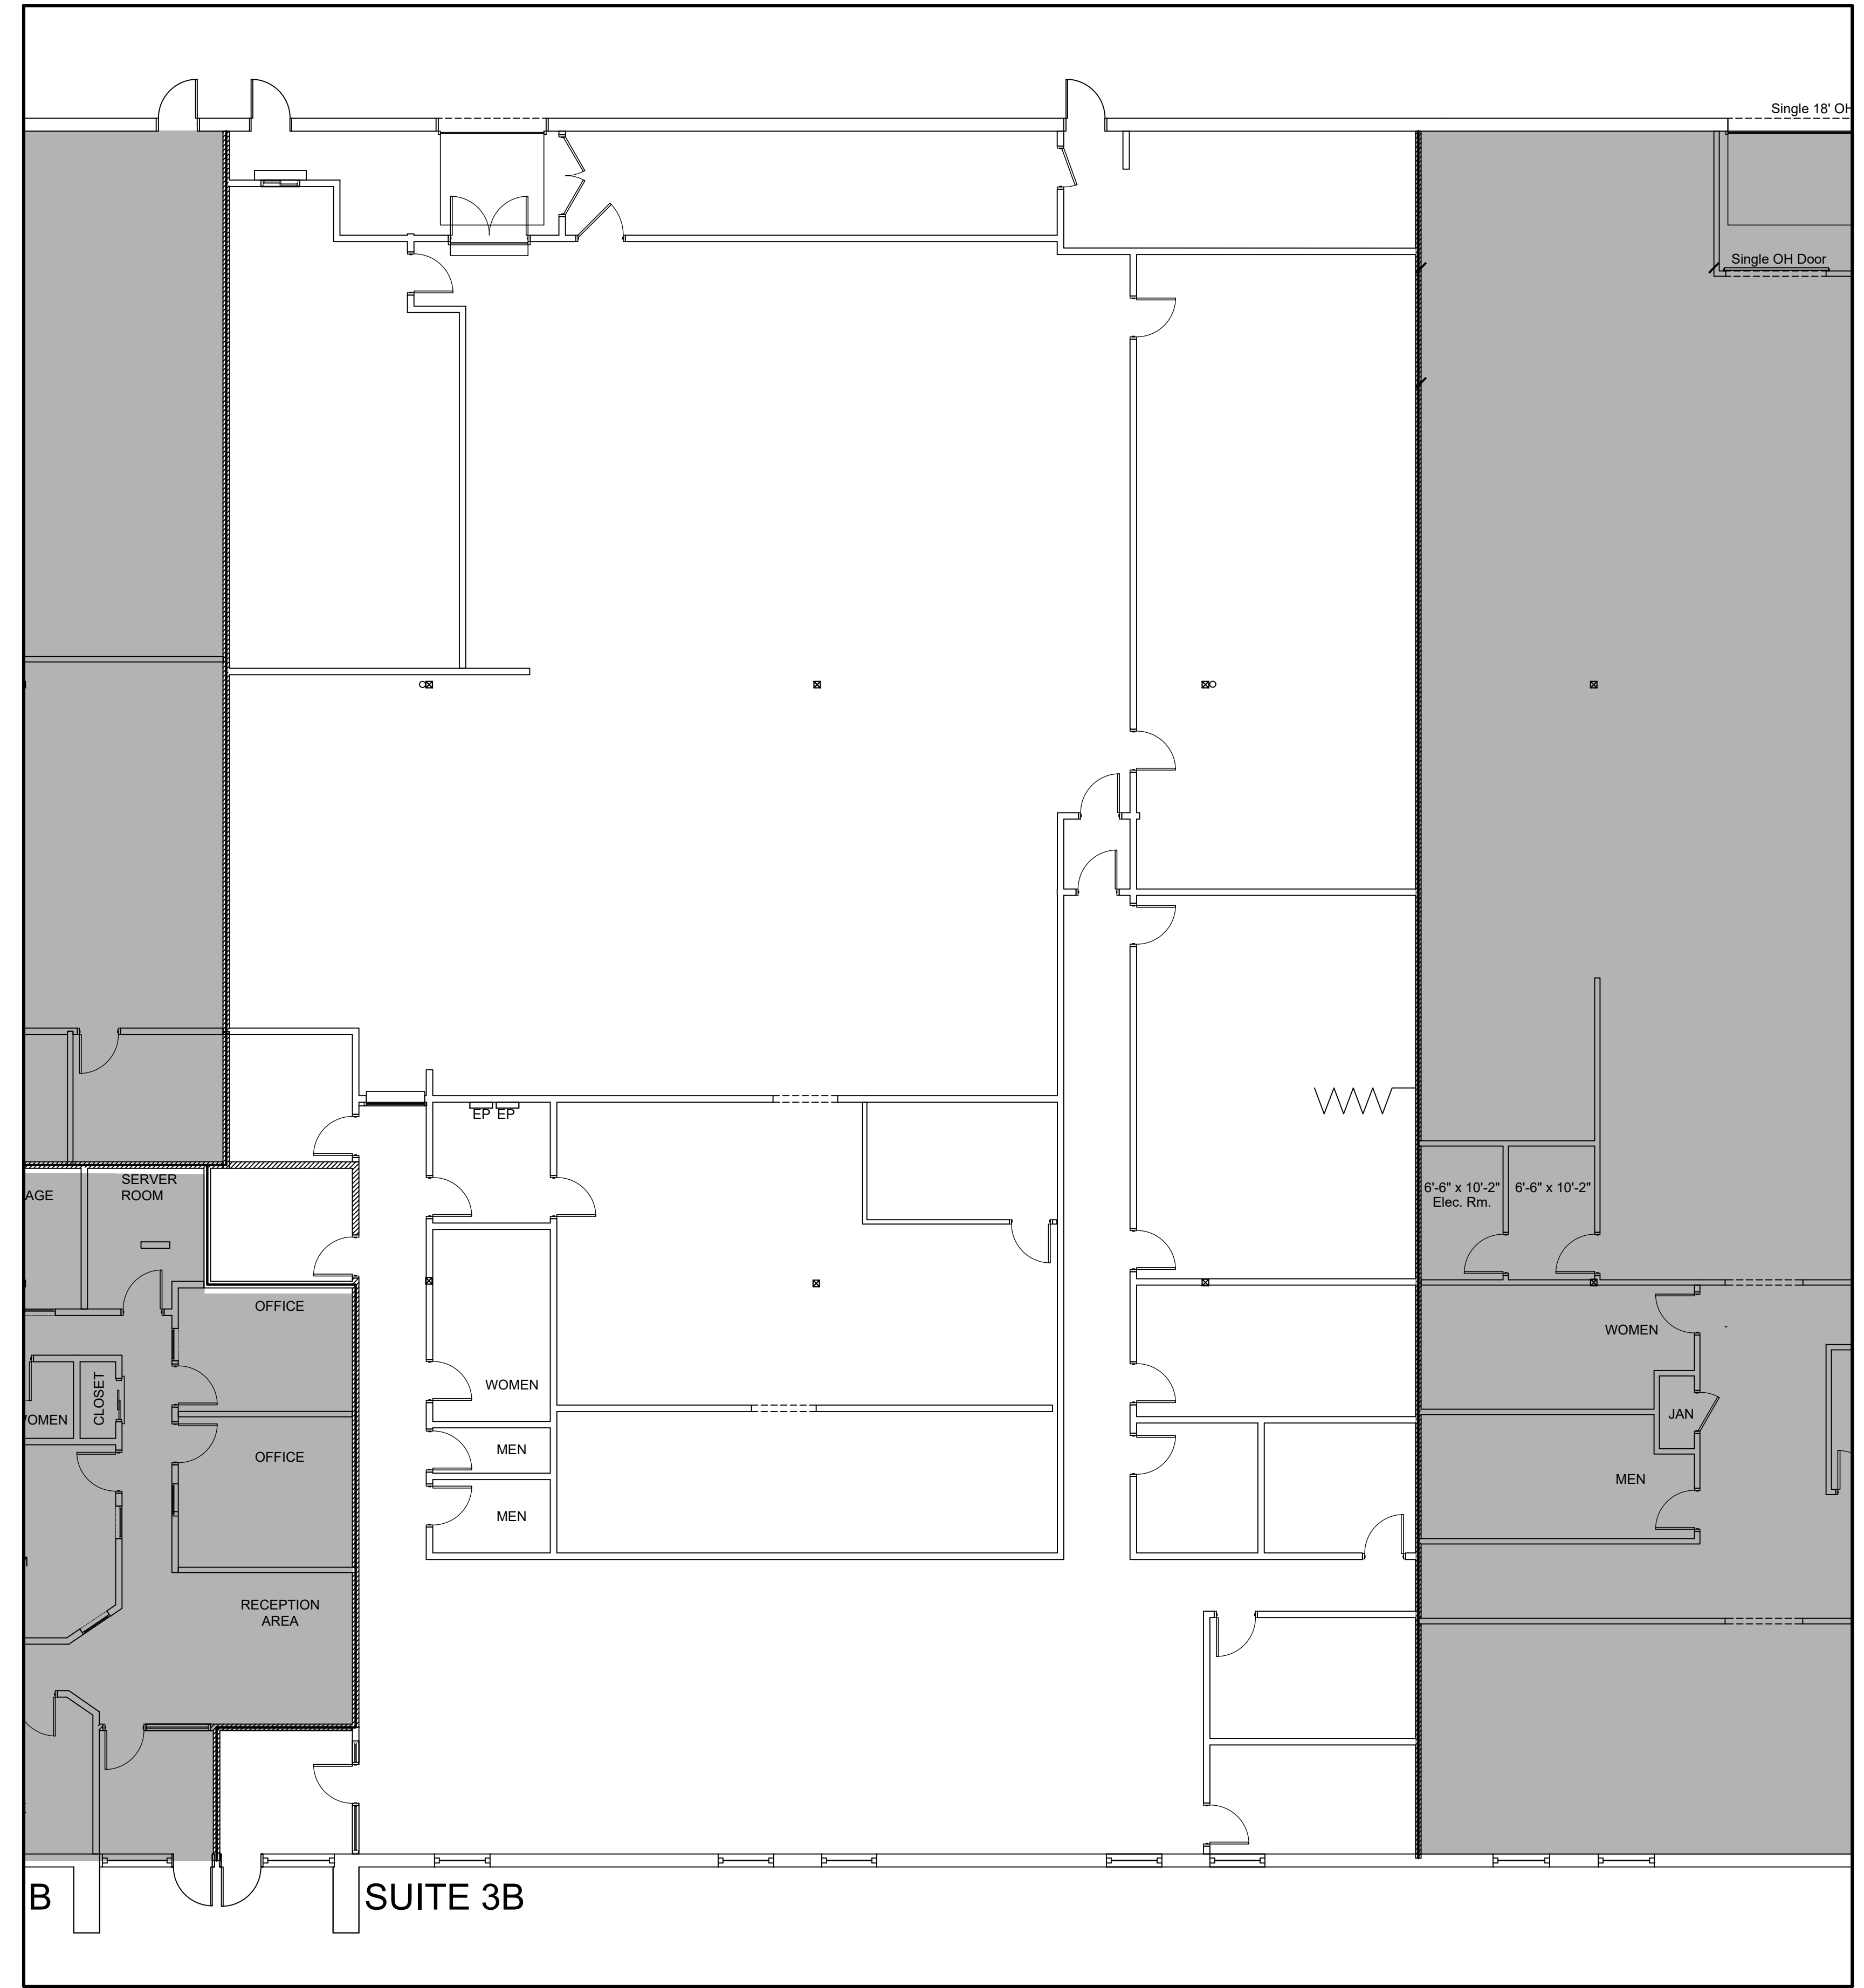

LOCATION PLAN